




SOUTH ELEVATION

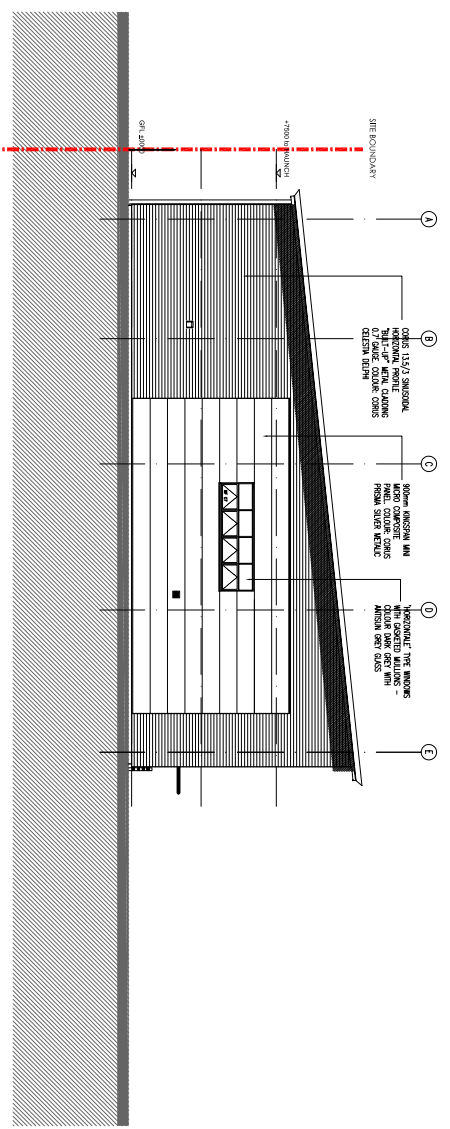

WEST ELEVATION

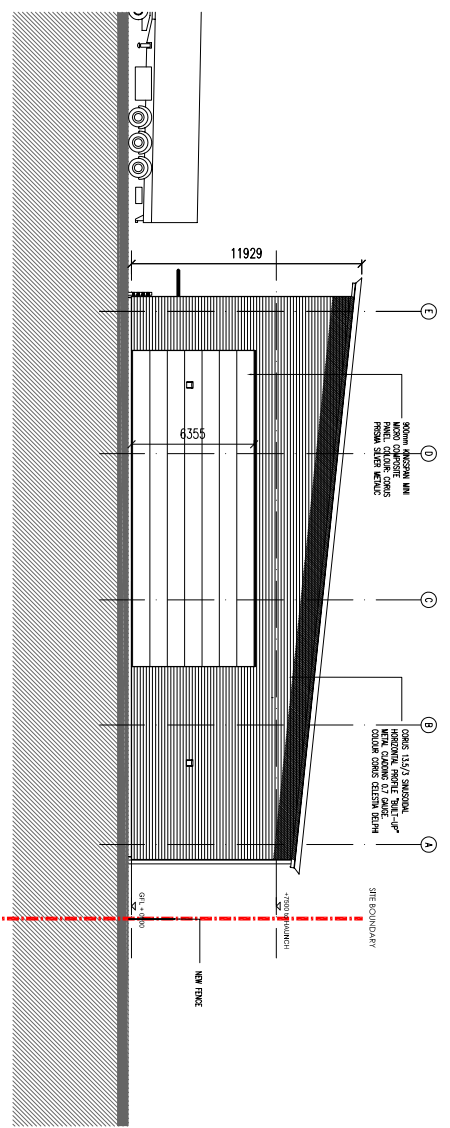

EAST ELEVATION

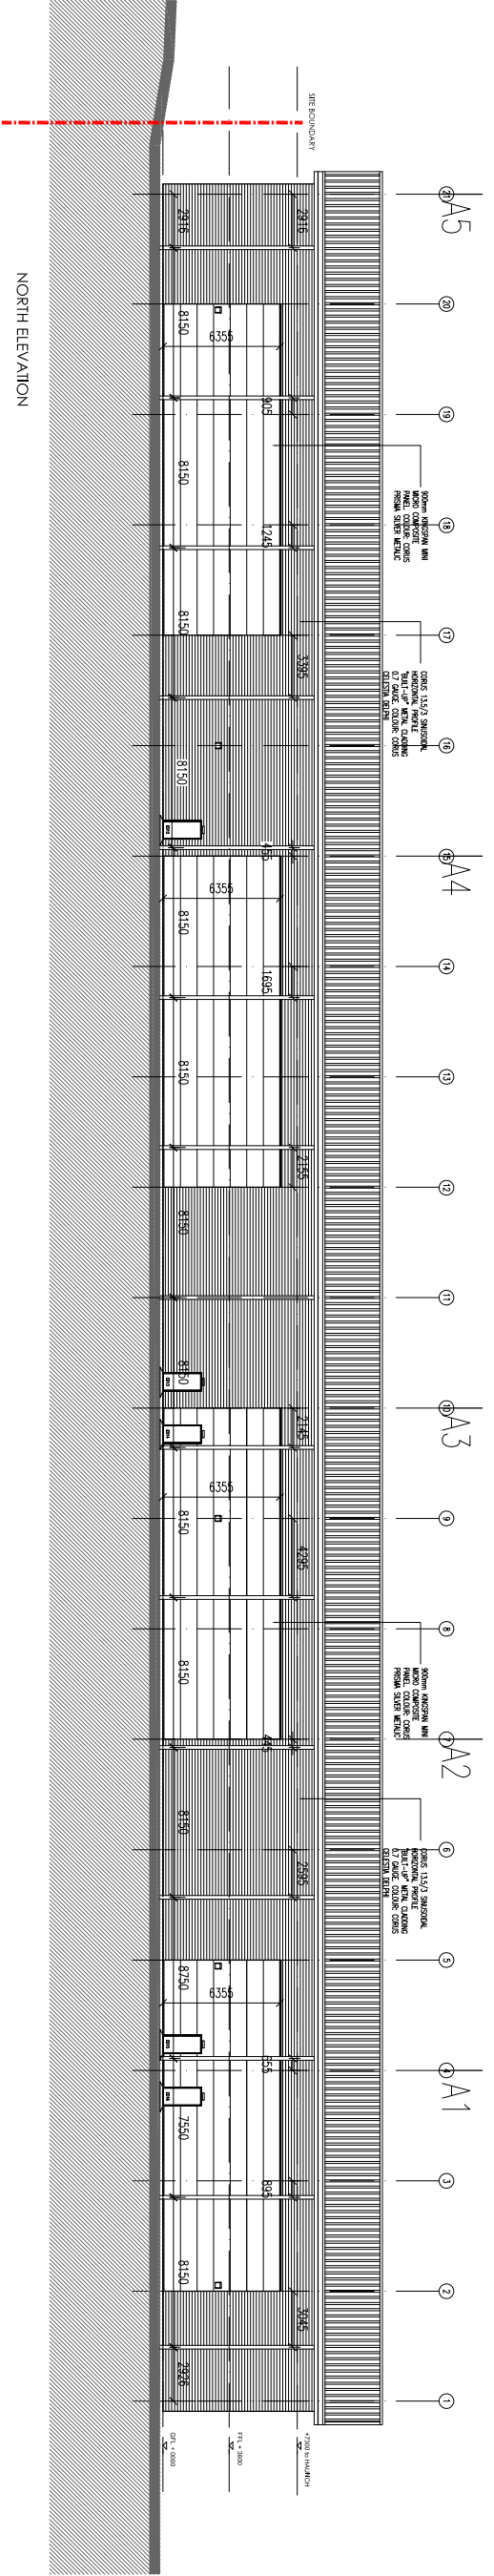

NORTH ELEVATION

SOUTHERN COMMERCIAL
 UNIT A - PROPOSED ELEVATIONS

DATE: | DRAWN BY: |
FletcherArchitects
 Designers & Master Planners
 UNITS 1 & 2 RIVERSIDE MEWS
 COMMERCIAL STREET
 MANCHESTER M13 9HQ
 T +44(0)161 838 5360
 F +44(0)161 838 5361
 office@fletcherarchitects-uk.com
 www.fletcherarchitects-uk.com

UNIT A - PROPOSED ELEVATIONS
 SOUTHERN COMMERCIAL

AS BUILT ISSUE

SCALE 1:200 @ A1

PROPOSED COMMERCIAL DEVELOPMENT
 for HELIOS (INDUSTRIAL DEVELOPMENTS) LTD
 UNIT A - PROPOSED ELEVATIONS
 STATUS: AB | P+ PRELIMINARY | 3 SHEETS | 22.03.07
 DRAWN: RCT | CHECKED BY: | 1:2000@A1
1221 - AB101 -