


NORTH ELEVATION ALONG G.L.E




EAST ELEVATION ALONG G.L. 1

WEST ELEVATION ALONG G.L. 21

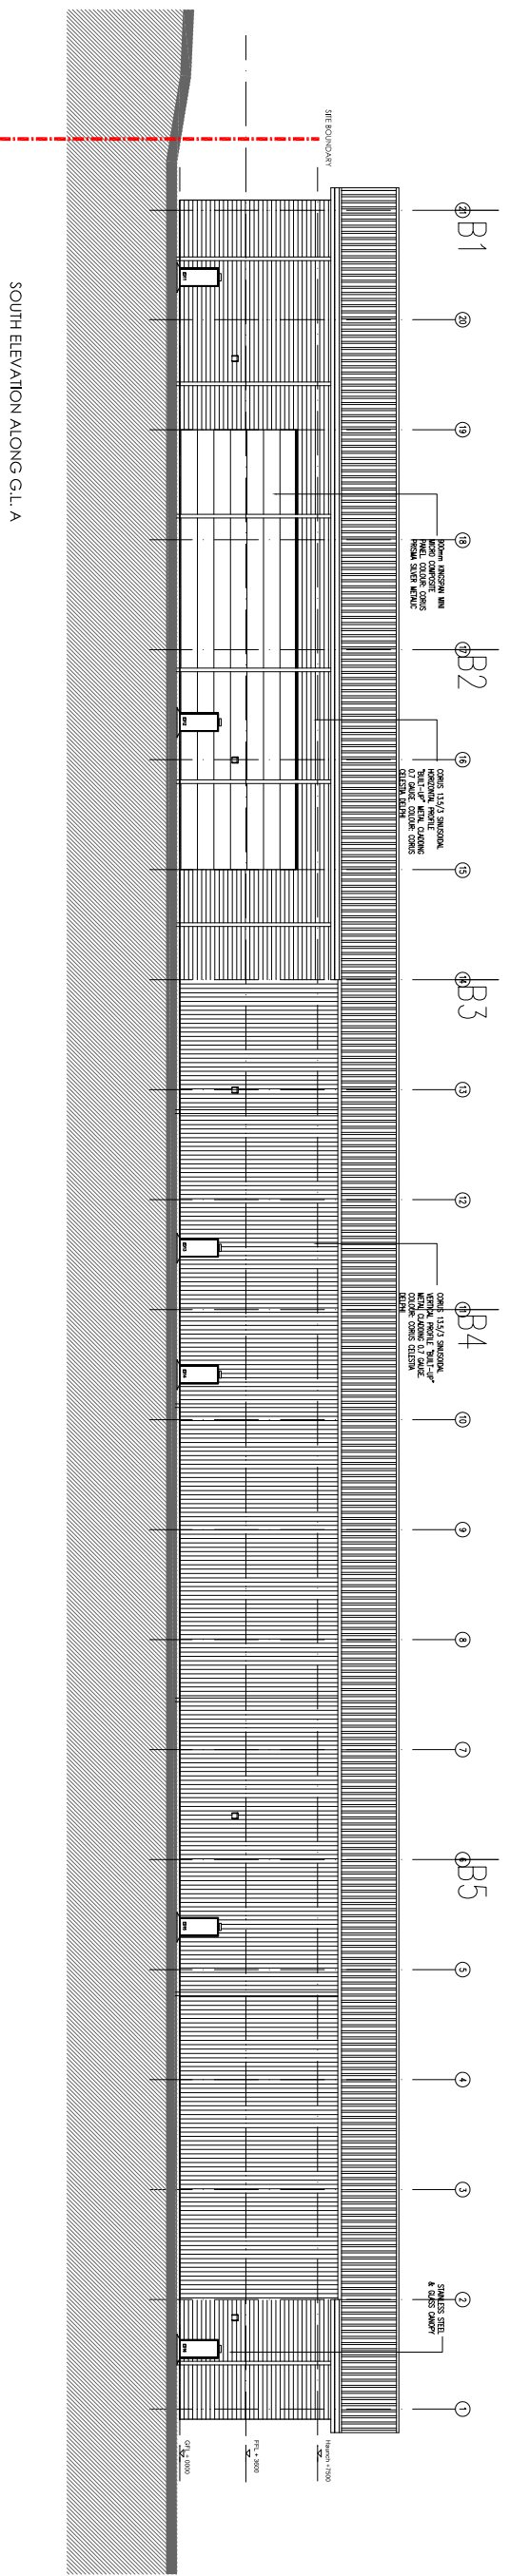

SOUTH ELEVATION ALONG G.L. A

SOUTHERN COMMERCIAL
 UNIT B - PROPOSED ELEVATIONS

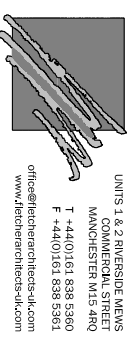

REV | DATE | DRAWN BY

UNIT B - PROPOSED ELEVATIONS
 SOUTHERN COMMERCIAL

AS BUILT ISSUE

SCALE 1:200 @ A1

PROPOSED COMMERCIAL DEVELOPMENT
 for HELIOS (INDUSTRIAL DEVELOPMENTS) LTD
 UNIT B - PROPOSED ELEVATIONS
 STATUSES AB 1 - 3
 DRAWN: RCT 1:2000@A1
 CHECKED BY: 1:2000@A1
 1221 - AB111 -