



1221 UNIT B  
 C20

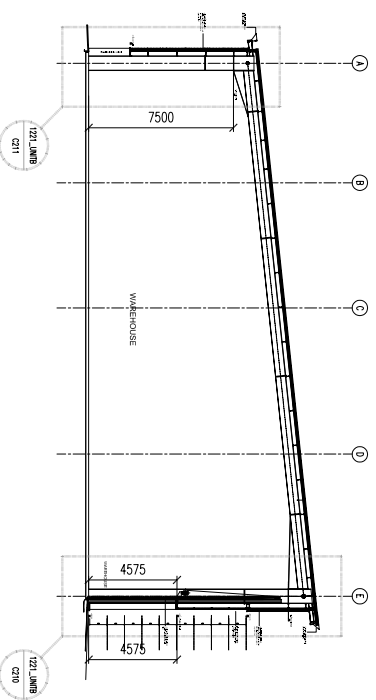


1221 UNIT B  
 C21

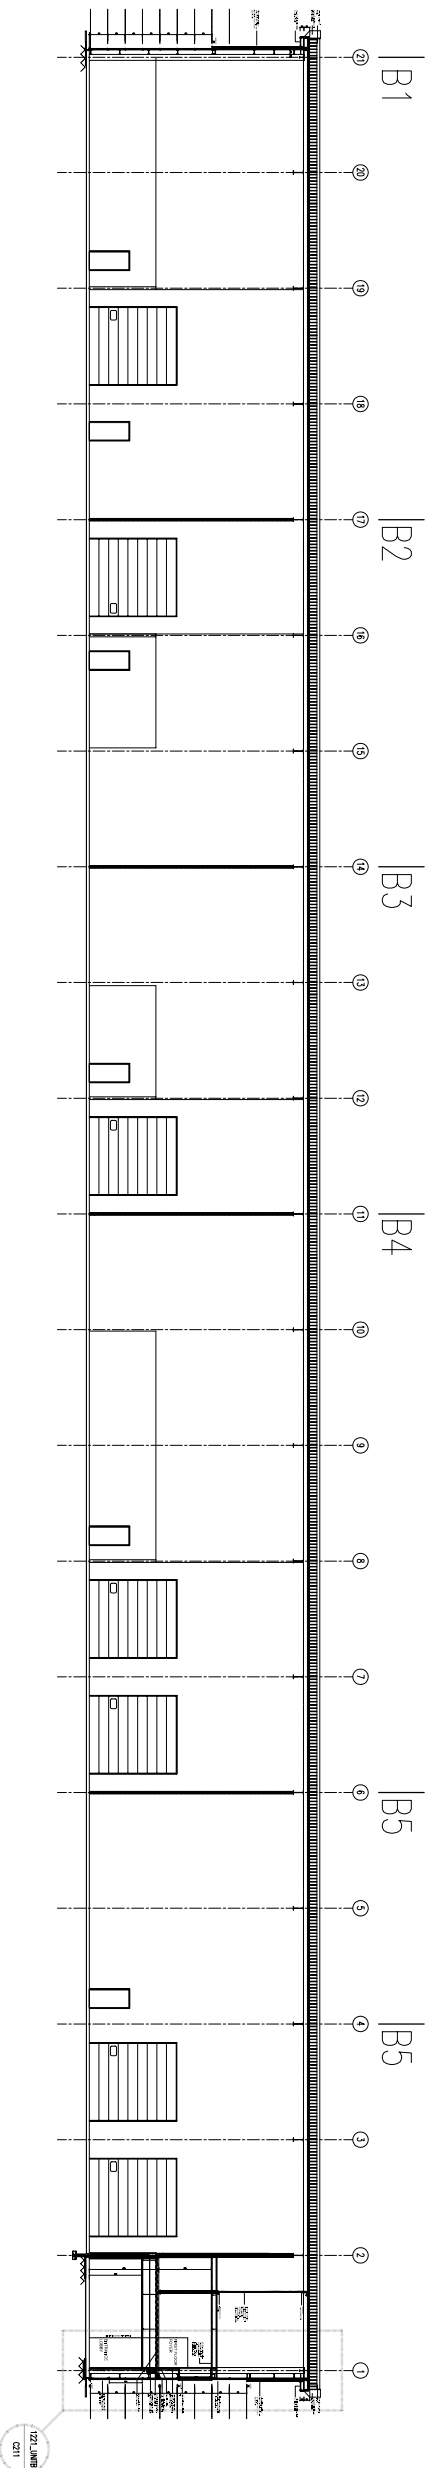

SECTION C-C

SOUTHERN COMMERCIAL  
 UNIT B - GA SECTION 1:100

AS1 23/01/08 file-curlrhn-odpdd RCT  
 Rev | Date | Drawn By

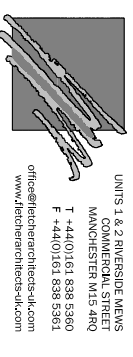

**FletcherArchitects**  
 Designers & Master Planners  
 UNITS 1 & 2 RIVERSIDE MEWS  
 COMMERCIAL STREET  
 MANCHESTER M13 9HQ  
 T +44(0)161 838 5360  
 F +44(0)161 838 5361  
 office@fletcherarchitects-uk.com  
 www.fletcherarchitects-uk.com

UNIT B - GA SECTION  
 SOUTHERN COMMERCIAL

AS BUILT ISSUE

SCALE 1:100 @ A1

PROPOSED COMMERCIAL DEVELOPMENT			
for HELIOS (INDUSTRIAL DEVELOPMENTS) LTD			
UNIT B - GA SECTION			
STATUS	AB	1 - 3/08	22.03.07
DRAWN BY	RCT	CHECKED BY	1:2000@A1
<b>1221 - AB112 AB1</b>			