




UNIT B4 GROUND FLOOR OFFICE CORE LAYOUT - UNIT B4

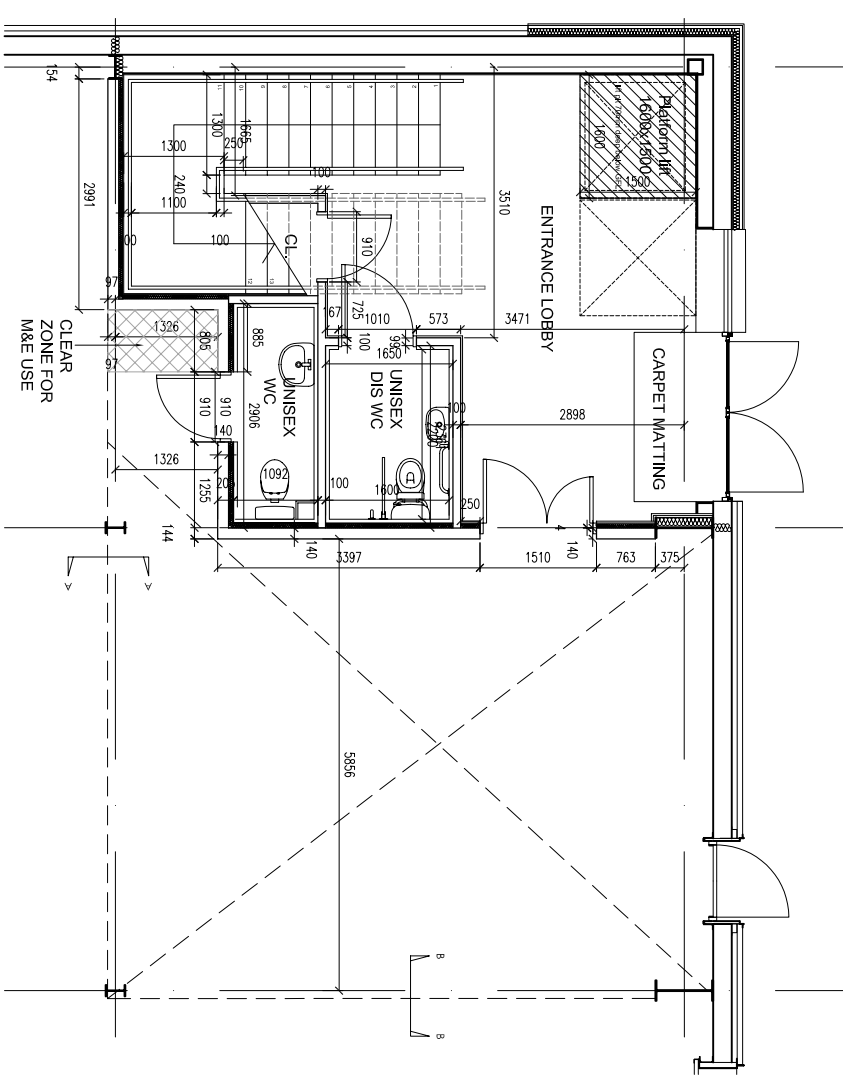

UNIT B1 GROUND FLOOR OFFICE CORE LAYOUT - UNIT B1

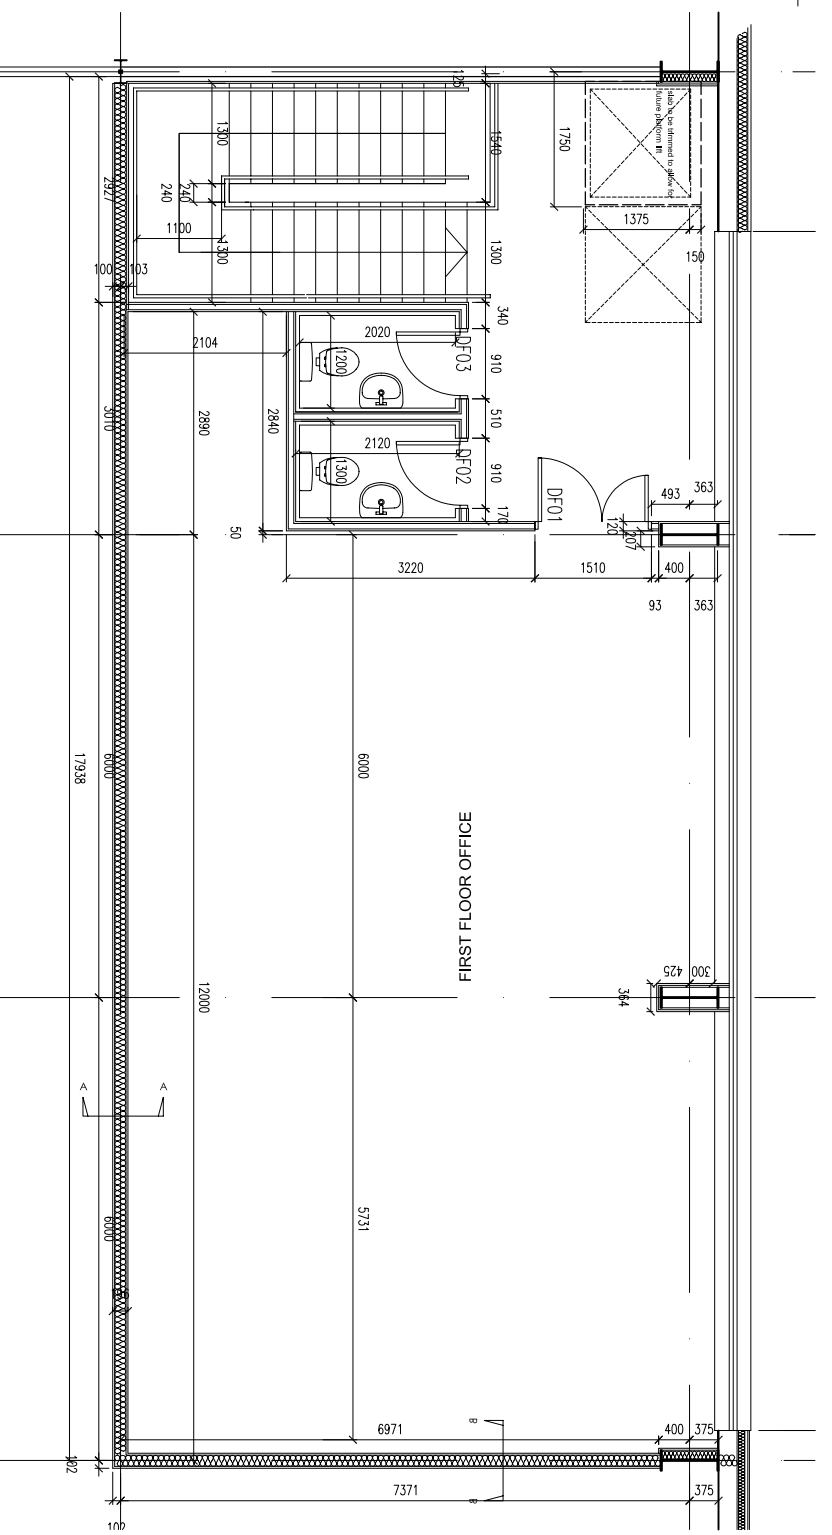

UNIT B4 FIRST FLOOR OFFICE CORE LAYOUT - UNIT B4

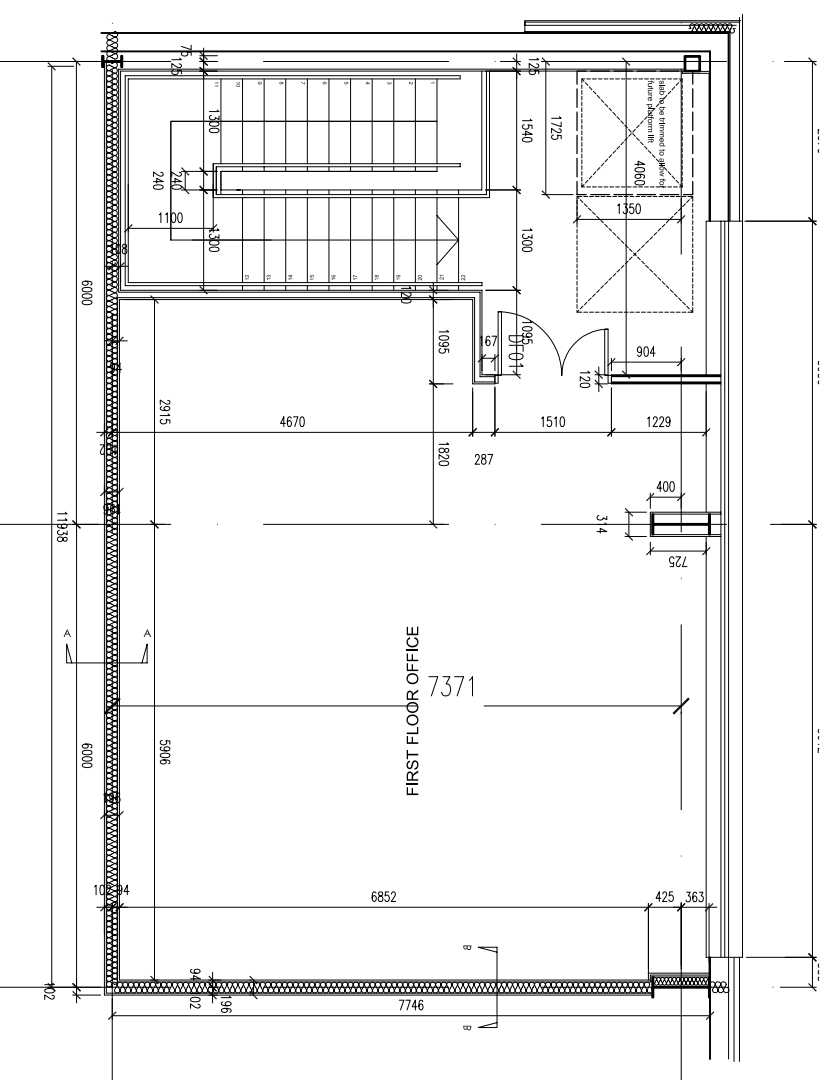

UNIT B1 FIRST FLOOR OFFICE CORE LAYOUT - UNIT B1

UNIT B - OFFICE CORE LAYOUTS  
SOUTHERN COMMERCIAL

AS BUILT ISSUE

SCALE 1:50 @ A1

Copyright Reserved to Fletcher Architects UK Ltd  
These plans and specifications are the property of Fletcher Architects UK Ltd. No part of this document may be reproduced, stored in a retrieval system, or used in any form or by any means, without the prior written consent of Fletcher Architects UK Ltd. Any use of this document without the written consent of Fletcher Architects UK Ltd is prohibited.

**SOUTHERN COMMERCIAL**  
UNIT B - OFFICE CORE LAYOUTS 1:50

**FletcherArchitects**  
Designers & Master Planners

UNITS 1 & 2 RIVERSIDE MEWS  
COMMERCIAL STREET  
MANCHESTER M13 9NQ  
T +44(0)161 838 5360  
F +44(0)161 838 5361  
office@fletcherarchitects-uk.com  
www.fletcherarchitects-uk.com

PROPOSED COMMERCIAL DEVELOPMENT  
for HELIOS (INDUSTRIAL DEVELOPMENTS) LTD  
UNIT B - OFFICE CORE LAYOUTS  
STATUS: AB | 1:50 | 22.03.07  
DRAWN: RCT | CHECKED BY: 1:50@A1  
**1221 - AB114**