


GROUND FLOOR OFFICE



FIRST FLOOR OFFICE

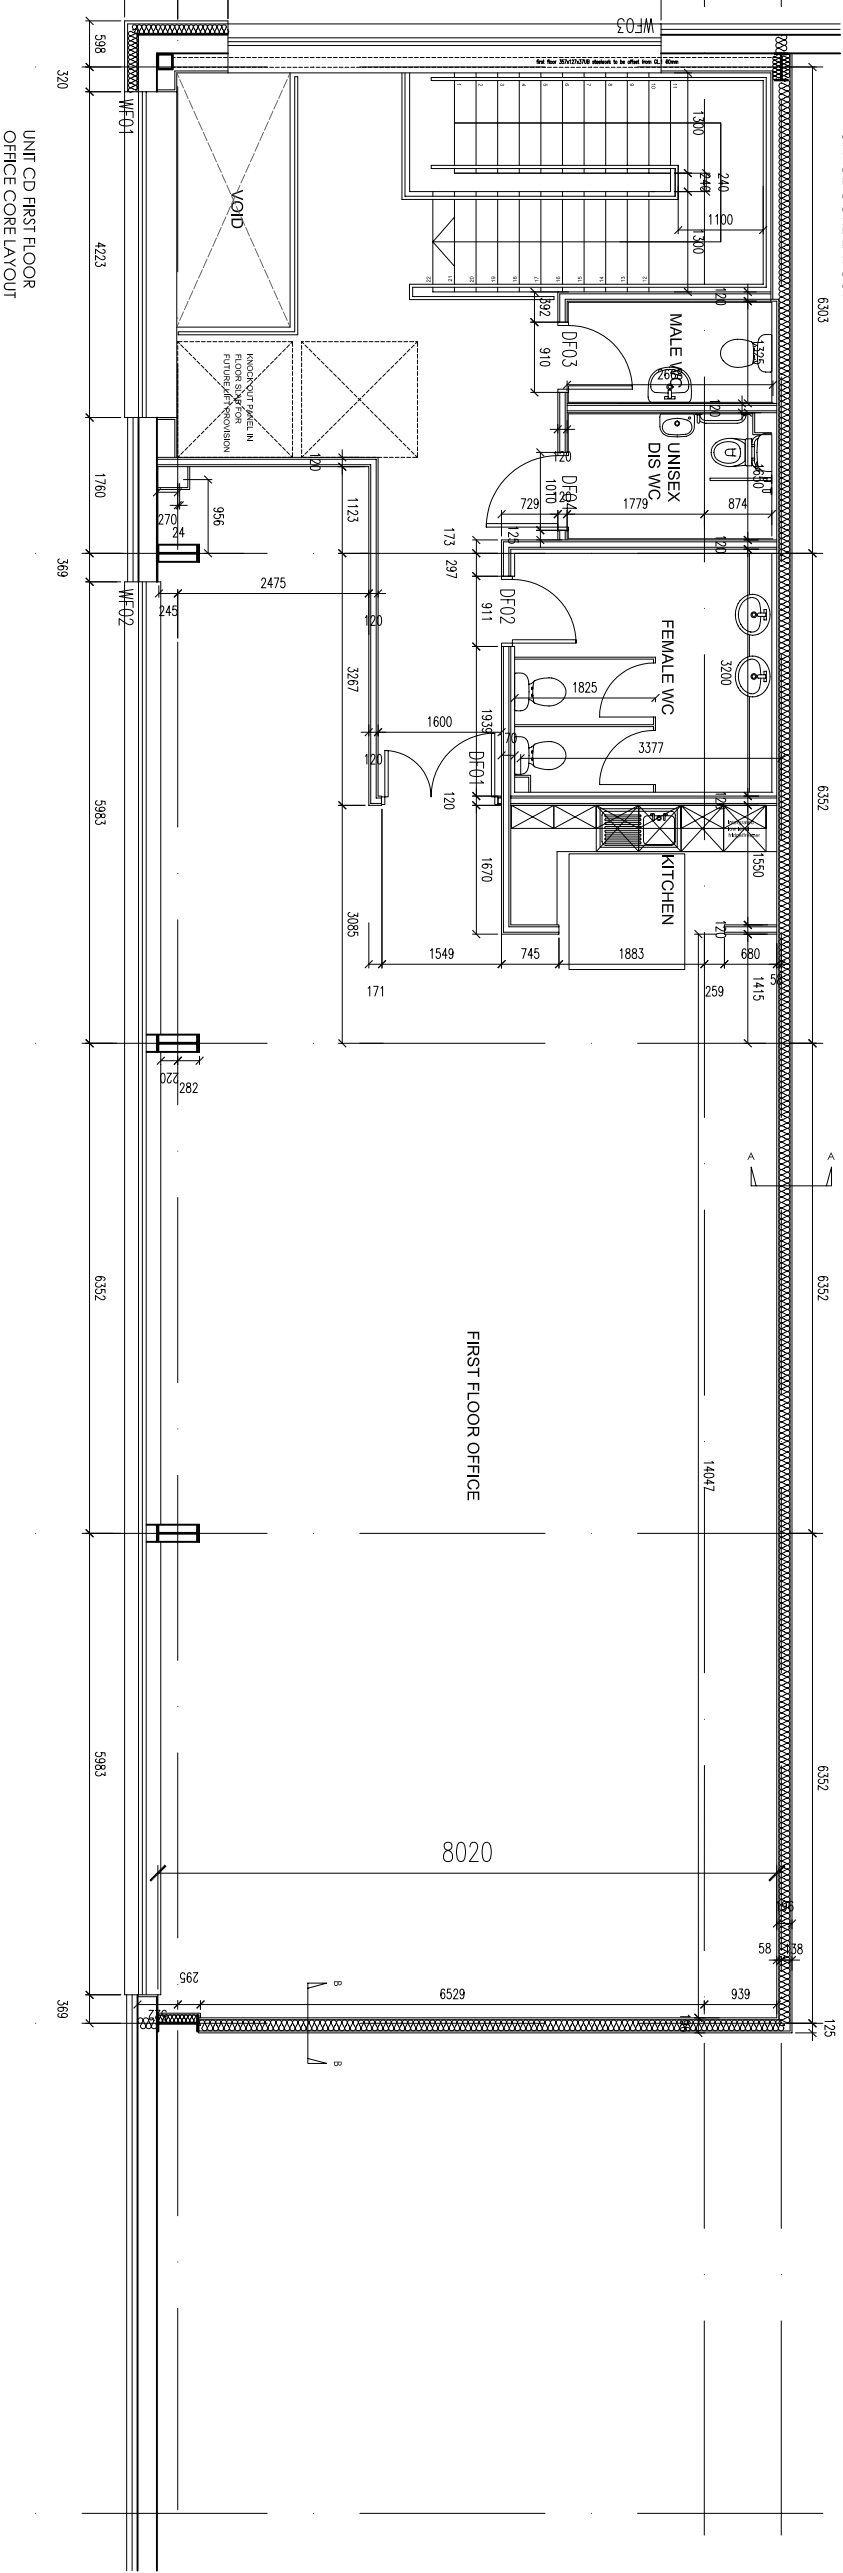

UNIT CD FIRST FLOOR OFFICE CORE LAYOUT

UNIT C - OFFICE CORE LAYOUT
SOUTHERN COMMERCIAL

AS BUILT ISSUE

SCALE 1:50 @ A1

SOUTHERN COMMERCIAL
UNIT C - OFFICE CORE LAYOUT 1:50

AB2 (S&B) Approved to build to and build to Control Document
AB1 (1/11/17) Show to DC/MS/Control Document
RGT
RGT
RGT

FletcherArchitects
Designers & Master Planners

UNITS 1 & 2 RIVERSIDE MEWS
COMMERCIAL STREET
MANCHESTER M13 9HQ
T +44(0)161 838 5360
F +44(0)161 838 5361
office@fletcherarchitects-uk.com
www.fletcherarchitects-uk.com

PROPOSED COMMERCIAL DEVELOPMENT
for HELIOS (INDUSTRIAL DEVELOPMENTS) LTD
UNIT C - OFFICE CORE LAYOUT
STATUS: AB 1:50
DRAWN: RGT 1:50
CHECKED BY: RGT 1:50
DATE: 04.04.07
SCALE: 1:50 @ A1
1221 - AB123 AB2