




**SOUTH ELEVATION**

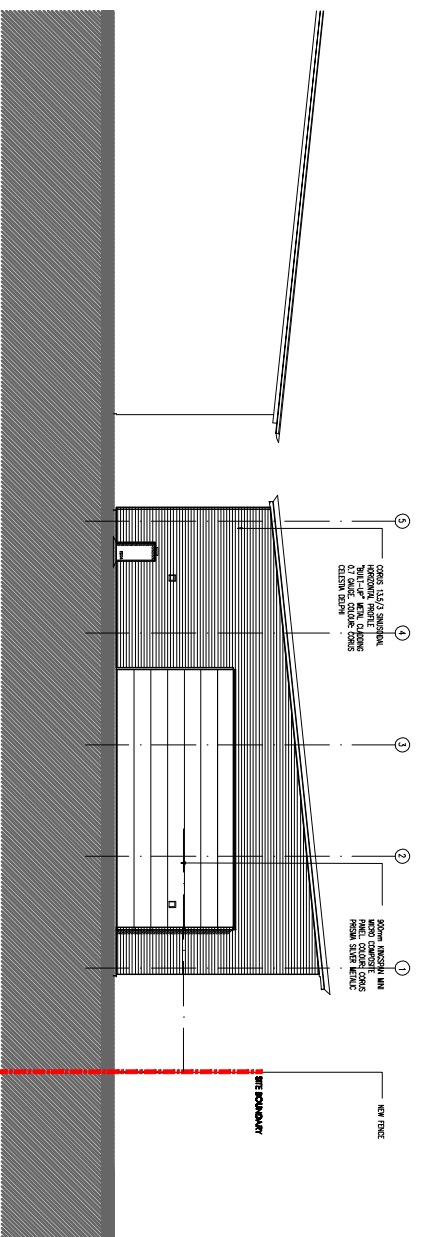

**NORTH ELEVATION**

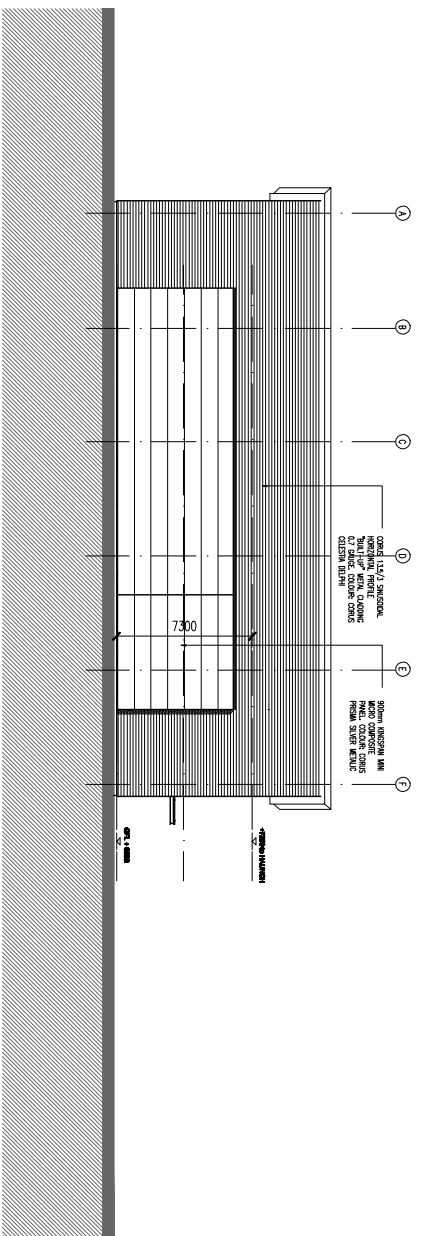

**WEST ELEVATION**

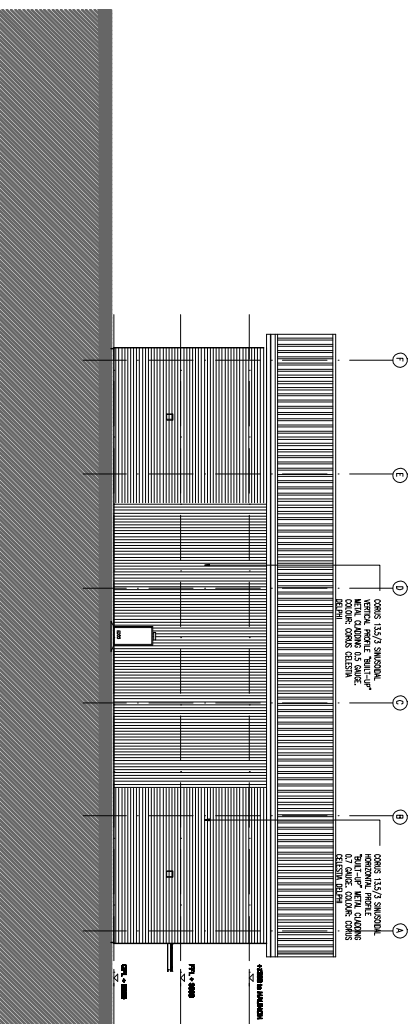

**EAST ELEVATION**

**UNIT G - ELEVATION  
 SOUTHERN COMMERCIAL**

**SOUTHERN COMMERCIAL**  
 UNIT GA - PROPOSED GA PLAN 1:1:100

REV / DATE SCALE BY

**FletcherArchitects**  
 Designers & Master Planners

UNITS 1 & 2 RIVERSIDE MAJNIS  
 COMMERCIAL STREET  
 MANCHESTER M15 4RQ  
 T +44(0)161 888 1890  
 F +44(0)161 888 1391  
 www.fletcherarchitects-uk.com

PROPOSED COMMERCIAL DEVELOPMENT  
 for HELIOS (INDUSTRIAL DEVELOPMENTS) LTD  
 UNIT G - ELEVATIONS  
 STATUS: AS 1:1:100 DATE: 30.04.07  
 DRAWN: RCT 1:1:100 CHECKED BY: 1:2000A/L

**AS BUILT ISSUE**  
 SCALE 1:200 @ A1

**1221 - AB151**