helioscity

Copyright Reserved to Fletcher Architects UK Ltd

These plans and specifications are the property of Fletcher Architects UK Ltd, and shall not be re-plotted or reproduced, in whole or part, without their written consent, nor shall any building or structure be constructed in accordance with such plans and specifications or any modifications thereof without the written consent of Fletcher Architects UK Ltd.

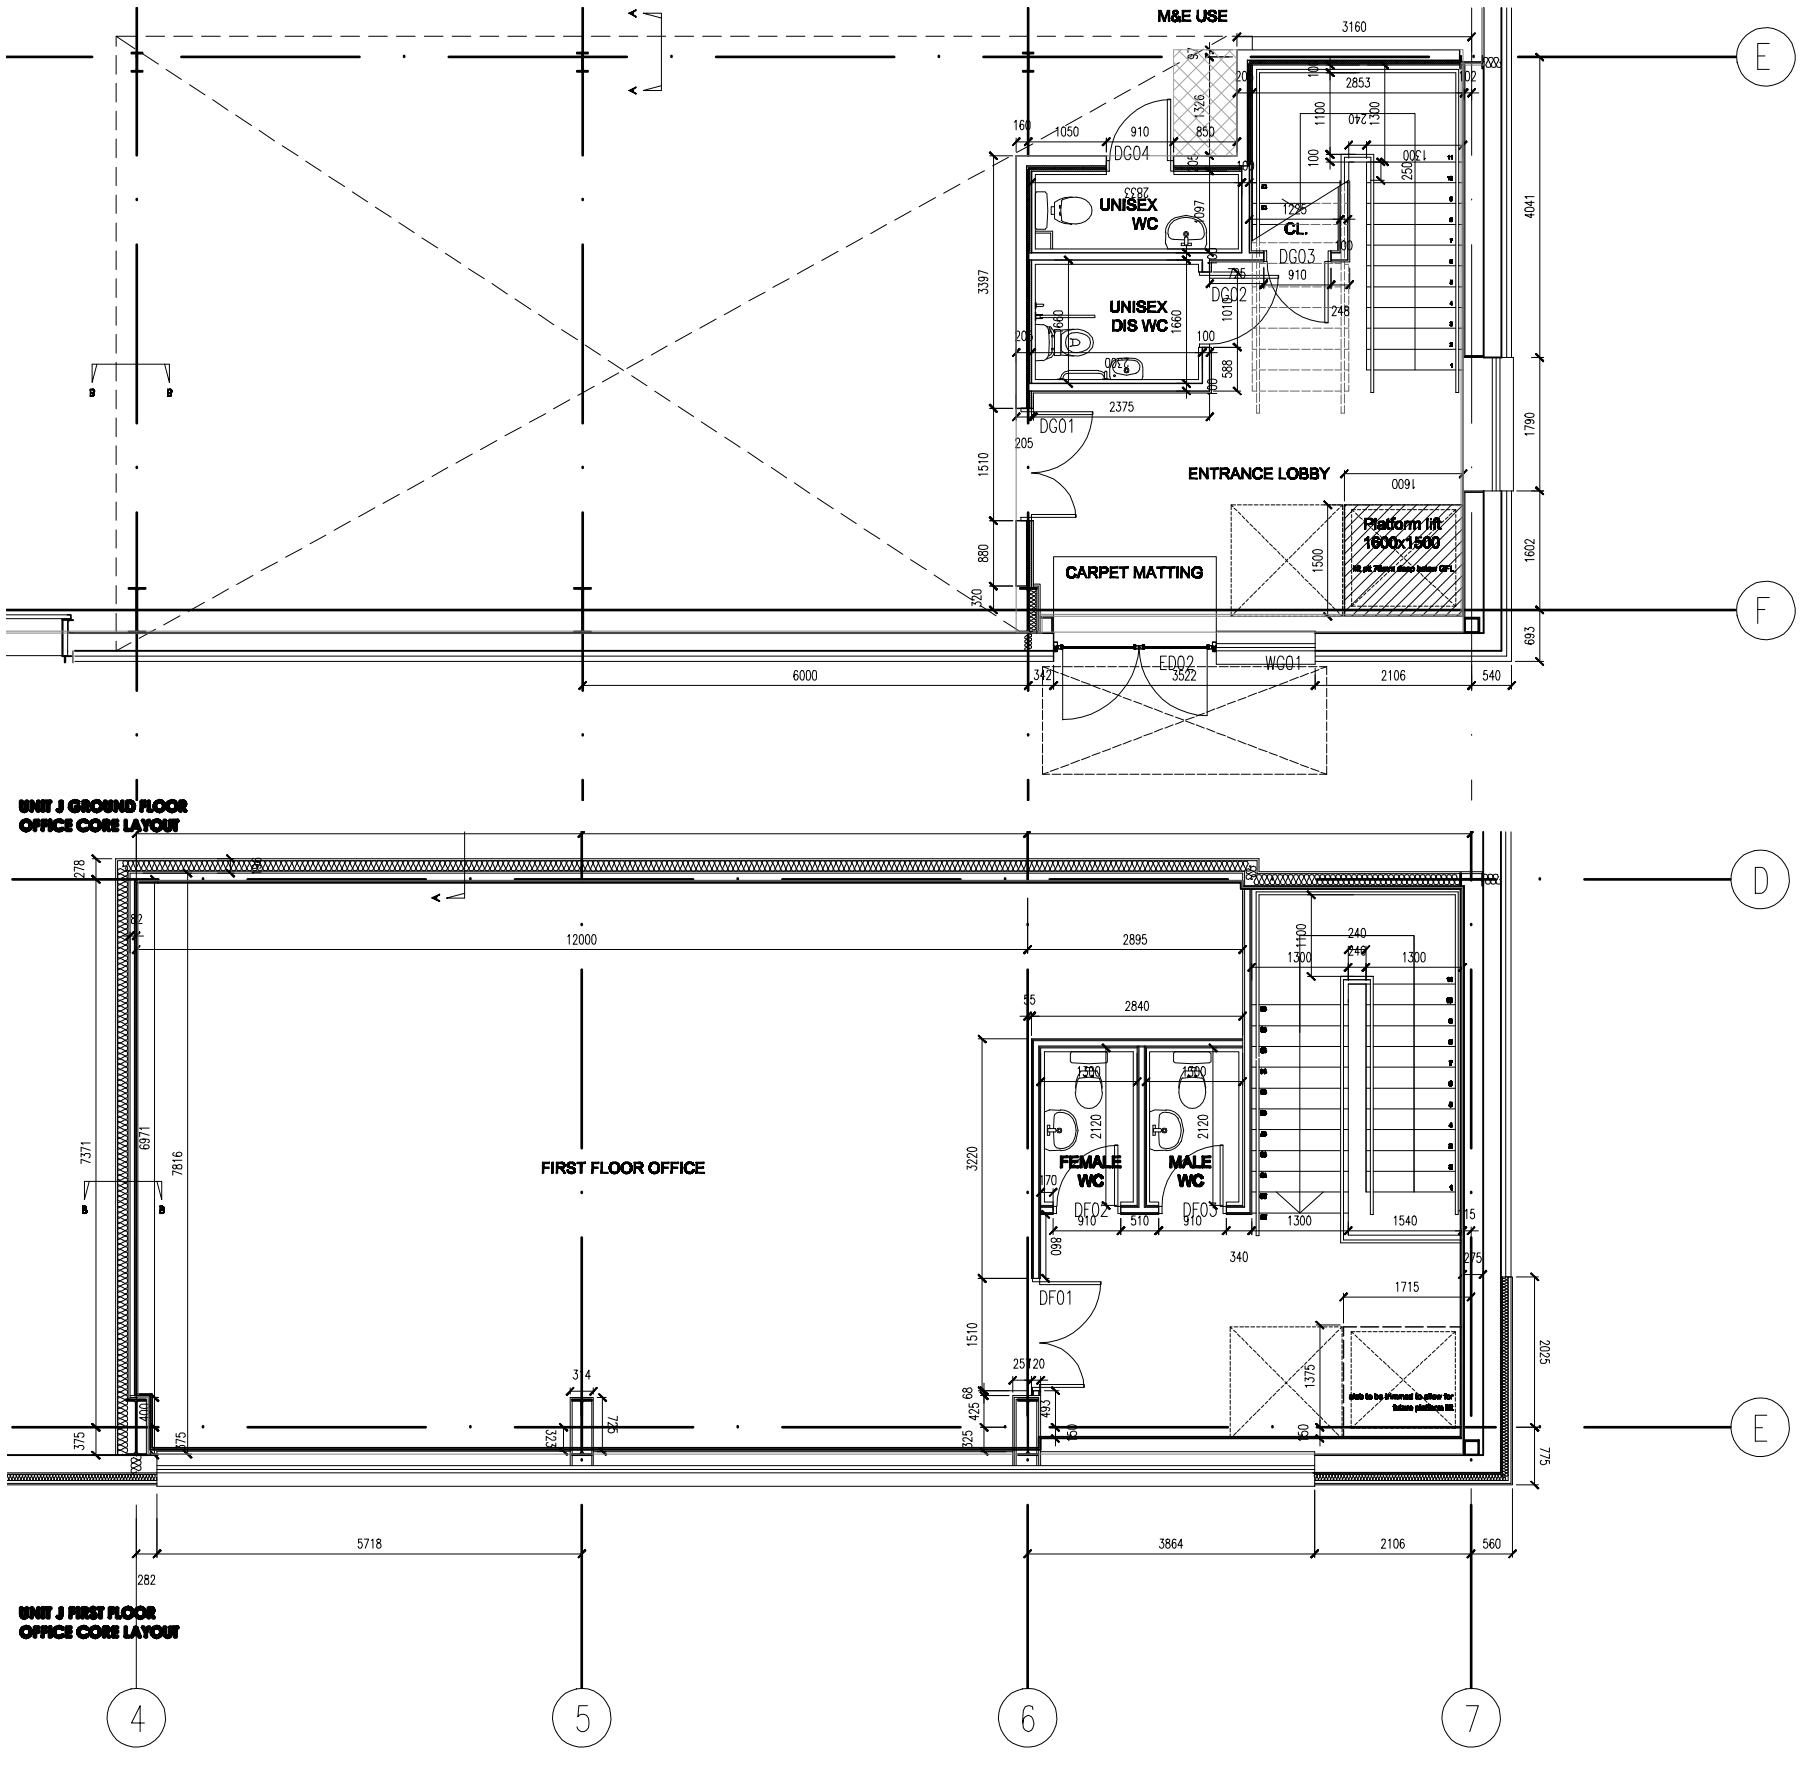

SOUTHERN COMMERCIAL

UNIT J - OFFICE CORE LAYOUTS 1:50

Fletcher Architects
Designers & Master Planners

HILL QUAYS
5 JORDAN STREET
MANCHESTER
M15 4PY
T +44(0)161 242 1140
F +44(0)161 242 1141
office@fletcherarchitects-uk.com
www.fletcherarchitects-uk.com

REV	DATE		DRAWN BY

PROPOSED COMMERCIAL DEVELOPMENT
for HELIOS (INDUSTRIAL DEVELOPMENTS) LTD
UNIT J - OFFICE CORE LAYOUT

STATUS	AB	P = PRELIMINARY C = CONSTRUCTION	T = TENDER S = SKETCH	30.05.07
DRAWN :	RCT	CHECKED BY:		1:50@A1

1221 - AB163 | -

UNIT J - OFFICE CORE LAYOUT
SOUTHERN COMMERCIAL

AS BUILT ISSUE

SCALE 1:50 @ A1